



Green Star - Office Interiors v1.1

Management

Man-3 Commissioning - Tenancy Fitout Tuning

Points Available	Points Claimed	CIR Submitted
N/A	N/A	N

Credit Criteria


If the fitout is less than 1000m² or if only minor or no alterations to base building services are undertaken, or no supplementary building services are installed, then this credit is 'Not Applicable' - type "na" in the 'No. of Points Achieved' column.

Documents Provided

✓	As-built drawings that indicate that the NLA is less than 1000m². Man-3: 1
----------	----------------------------------------------------------------------------

Discussion

In order to demonstrate that the NLA of the tenancy is less than 1000m², we have marked up an as-built drawing, showing calculations that confirm the NLA to be compliant at 804m².

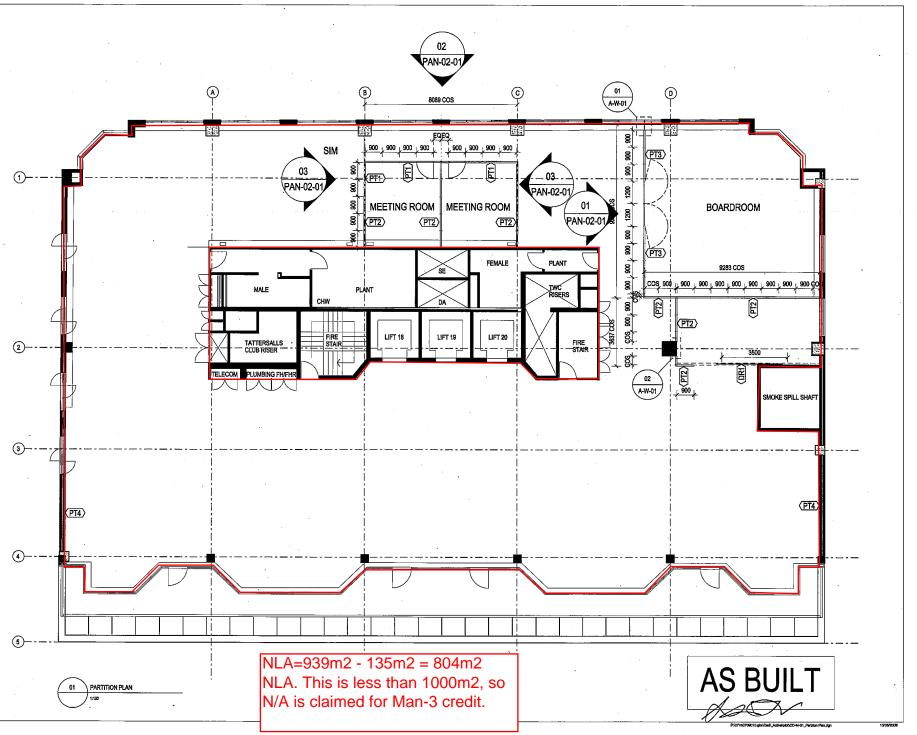



BlighVollerNieldArchitecture

Telephone +61 3 9639 918 Facsimile +61 3 9639 9188 www.bvn.com.au

INTELLECTUAL PROPERTY
SOUTHWAS EXCULAIN BELLEY TOU, THAN I MAJES OTHERWISE
AGRESS INVESTIGE, ALL REACH TO LISE, THE DOCUMENT AND RESIDENCE
FOR THE THE PROPERTY OF THE THE COLLEGE THE SHARE OF THE SHARE
RELIES OF THE DOCUMENT AND RELIES OF THE SHARE
RELIES OF THE SHARE OF THE SHARE OF THE SHARE OF THE SHARE
RELIES OF THE SHARE OF THE SHARE OF THE SHARE OF THE SHARE
MAY COLLEGE THE SHARE OF THE SHARE OF THE SHARE OF THE SHARE
RELIES OF THE SHARE OF THE SHARE OF THE SHARE OF THE SHARE
RELIES OF THE SHARE OF THE SHARE OF THE SHARE OF THE SHARE
RELIES OF THE SHARE OF THE SHAR

ISSUE	DATE	FOR	
01	11.10.07	PRICING	
. 02 .	17.10.07	APPROVAL	
03	17,10.07	APPROVAL	
C4	05.11.07.	ADDED P4. UPDATED FINISH TO DR1	
A	09.11.07	FOR CONSTRUCTION	
В	11.12.07	DOOR HARDWARE ADDED	

CONSULTANT
DAVIS LANGDON
tel 02 9956 8822 fax 02 9956 8848
CONSULTANT
LINCOLNE SCOTT
tel 02 8907 0900 fax 02 9957 4127


GBCA L15, 179 ELIZABETH STREET SYDNEY NSW 2000

PROJECT

CLIENT PROJECT No.

GREEN BUILDING COUNCIL OF AUSTRALIA

BVN PROJECT NUMBER

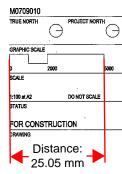

PARTITION PLAN
DRAWING NUMBER ISSUE
A-M-01 B