

Green Star – Office Interiors v1.1

Indoor Environment Quality IEQ-4 Daylight Glare Control

| Points Available | Points Claimed | CIR Submitted |
|------------------|----------------|---------------|
| 2 | 1 | N |

Credit Criteria

Up to two points are awarded where it is demonstrated that glare is reduced, as follows:

- 1 point is awarded where automated blinds/screens with a Visual Light Transmittance (VLT) of less than 10% and a manual override function are installed by either the tenant or the base building owner to reduce glare associated with natural lighting and eliminate all direct sun penetration;
- 1 point is awarded where all workstation monitors provided as part of the tenancy fitout are flat-screen and are mounted on an adjustable arm that enables the monitor to be pivoted and adjusted horizontally and vertically.

Documents Provided

| | |
|---|--|
| ✓ | As-built architectural drawings that show the location of blinds/screens included in the tenancy fitout and marked up to show how all direct sunlight penetration is controlled; |
| ✓ | A copy of the data sheet that shows the VLT properties for the installed blinds/screens; |
| ✓ | Information confirming the installed blinds/screens are connected to an automated control system with a manual override function that enables occupant control; and |
| ✓ | Information from the supplier/installer that quantifies all products supplied and installed in fitout. |

Discussion

- Verosol blinds have been installed in all perimeter windows to control daylight glare. They are connected to the Dynalite touch screen and are automated with manual override.
- An as-built architectural plan has been provided to show that blinds have been installed on all windows. An elevation as-built drawing has been provided to show how blinds prevent direct sunlight penetration. An electrical as-built drawings has been provided to demonstrate that all blinds are connected to a relay controller for automation and manual override function.
- The VLT data sheet demonstrates that blinds used have a VLT of 5%.
- The letter from Dynalite demonstrates that blinds have been automated to raise and lower on a preset schedule with manual override from the Dynalite touch screen.
- Finally, supplier/installer invoices from Verosol demonstrate that the 68 roller blinds have been supplied and installed.



BlighVollerNieldArchitecture

Telephone +61 3 9639 9199
Facsimile +61 3 9639 9188
www.bvn.com.au

INTELLECTUAL PROPERTY
© COPYRIGHT BLIGH VOLLER NIELD PTY LTD (BVN), UNLESS OTHERWISE AGREED IN WRITING. ALL RIGHTS TO USE THIS DOCUMENT ARE SUBJECT TO PAYMENT IN FULL OF ALL BVN CHARGES. THIS DOCUMENT MAY ONLY BE USED FOR THE EXPRESS PURPOSE AND PROJECT FOR WHICH IT HAS BEEN CREATED AND DELIVERED, AS NOTIFIED IN WRITING BY BVN. AND THIS DOCUMENT MAY NOT BE OTHERWISE USED, OR COPIED, ANY UNAUTHORIZED USE OF THIS DOCUMENT IS AT THE USER'S SOLE RISK AND WITHOUT LIMITING BVN'S RIGHTS THE USER RELEASES AND INDEMNIFIES BVN FROM AND AGAINST ALL LOSS SO ARISING.

| ISSUE | DATE | FOR |
|-------|----------|------------------|
| A | 08.11.07 | FOR CONSTRUCTION |

CONSULTANT
DAVIS LANGDON
tel 02 9956 8822 fax 02 9956 8848
CONSULTANT
LINCOLNE SCOTT
tel 02 8907 0900 fax 02 9957 4127
CLIENT

GBCA
L15, 179 ELIZABETH STREET
SYDNEY NSW 2000
CLIENT PROJECT No.

PROJECT

**GREEN BUILDING COUNCIL
OF AUSTRALIA**
BVN PROJECT NUMBER

M0709010
TRUE NORTH PROJECT NORTH

GRAPHIC SCALE
0 2000 5000


SCALE
1:100 at A2 DO NOT SCALE
STATUS

FOR CONSTRUCTION
DRAWING

PERIMETER BLIND PLAN
DRAWING NUMBER ISSUE
A-J-01 A

LEGEND

BLI PERIMETER BLINDS
TYPE: AMBIENCE MOTORISED
FABRIC: SILVER SCREEN
SUPPLIER: VEROSOL

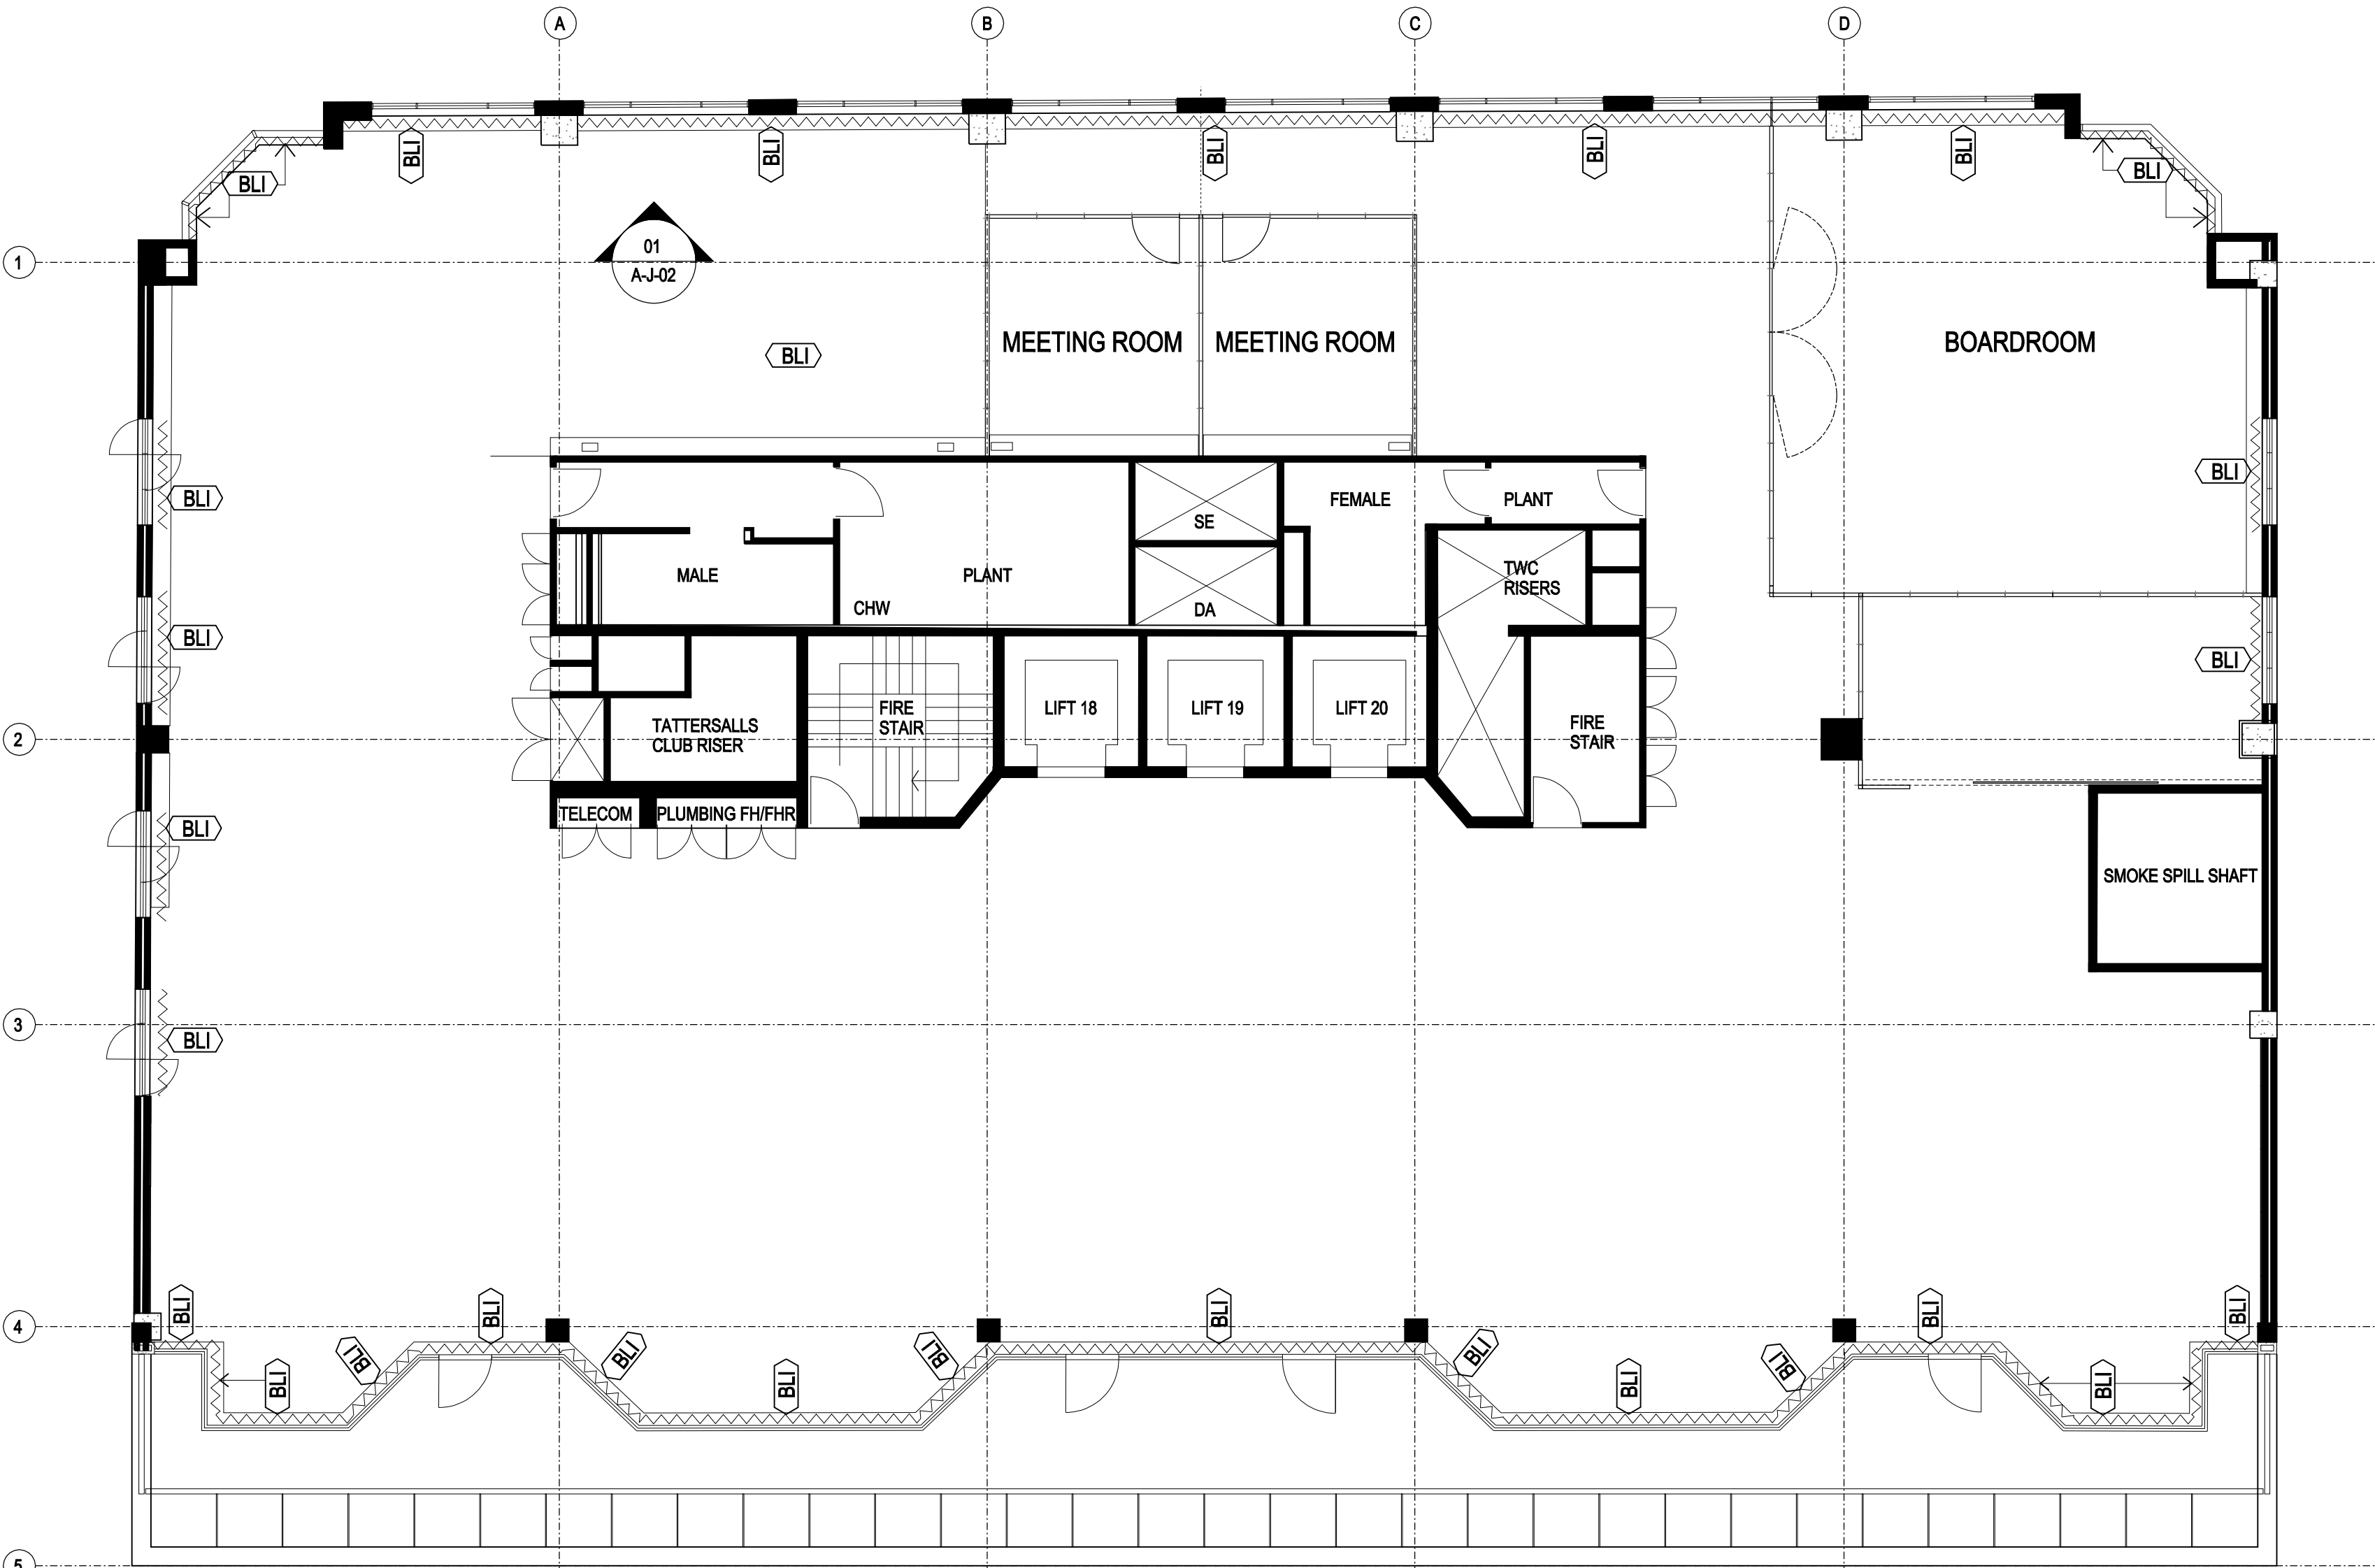

01 PERIMETER PLAN
1:100

AS BUILT



BlighVollerNieldArchitecture

Telephone +61 3 9639 9199
Facsimile +61 3 9639 9188
www.bvn.com.au

INTELLECTUAL PROPERTY

© COPYRIGHT BLIGH VOLLER NIELD PTY LTD (BVN), UNLESS OTHERWISE AGREED IN WRITING: ALL RIGHTS TO USE THIS DOCUMENT ARE SUBJECT TO PAYMENT IN FULL OF ALL BVN CHARGES. THIS DOCUMENT MAY ONLY BE USED FOR THE EXPRESS PURPOSE AND PROJECT FOR WHICH IT HAS BEEN CREATED AND DELIVERED, AS NOTIFIED IN WRITING BY BVN. AND THIS DOCUMENT MAY NOT BE OTHERWISE USED, OR COPIED, ANY UNAUTHORIZED USE OF THIS DOCUMENT IS AT THE USER'S SOLE RISK AND WITHOUT LIMITING BVN'S RIGHTS THE USER RELEASES AND INDEMNIFIES BVN FROM AND AGAINST ALL LOSS SO ARISING.

| ISSUE | DATE | FOR |
|-------|----------|------------------|
| A | 08.11.07 | FOR CONSTRUCTION |
| | | |
| | | |
CONSULTANT
DAVIS LANGDON
tel 02 9956 8822 fax 02 9956 8848

CONSULTANT
LINCOLNE SCOTT
tel 02 8907 0900 fax 02 9957 4127


CLIENT

GBCA
L15, 179 ELIZABETH STREET
SYDNEY NSW 2000
CLIENT PROJECT No.

PROJECT

GREEN BUILDING COUNCIL
OF AUSTRALIA
BVN PROJECT NUMBER

M0709010
TRUE NORTH PROJECT NORTH

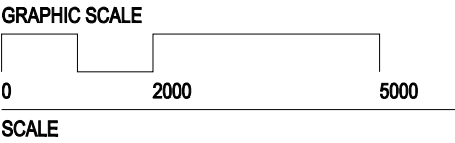


1:100 at A2 DO NOT SCALE
STATUS

FOR CONSTRUCTION
DRAWING

PERIMETER BLIND
ELEVATION PLAN


| DRAWING NUMBER | ISSUE |
|----------------|-------|
| A-J-02 | A |

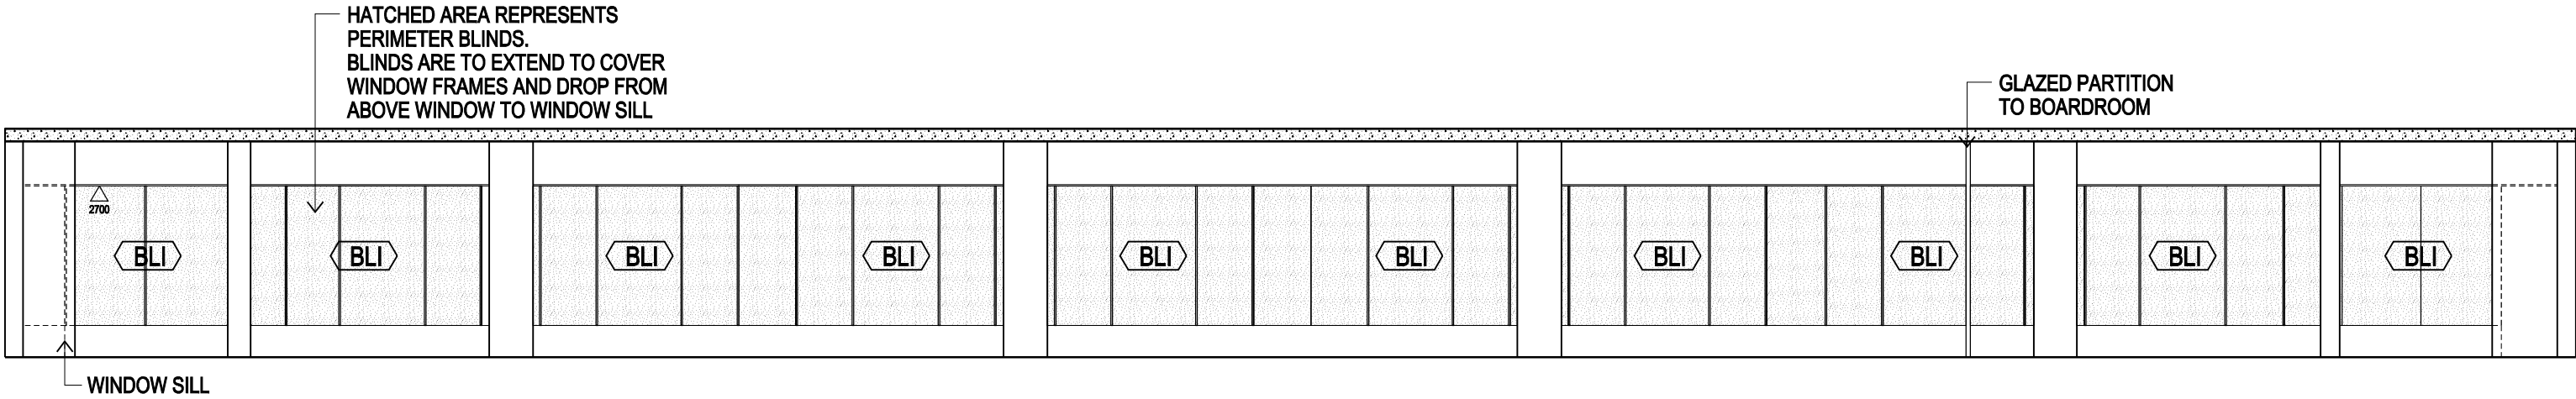



01 PERIMETER BLIND ELEVATION - WEST FACADE
1:100


AS BUILT

| DATE | REV | AMENDMENT | BY | CHKD |
|----------|-----|----------------------------|-----|------|
| 19.10.07 | A | TENDER | MPB | ASD |
| 12.11.07 | B | CONSTRUCTION ISSUE | MPB | ASD |
| 21.11.07 | C | REVISED CONSTRUCTION ISSUE | MPB | ASD |
| 28.11.07 | D | REVISED CONSTRUCTION ISSUE | MPB | ASD |
| 27.02.08 | E | AS INSTALLED | TC | |
| | | | | |

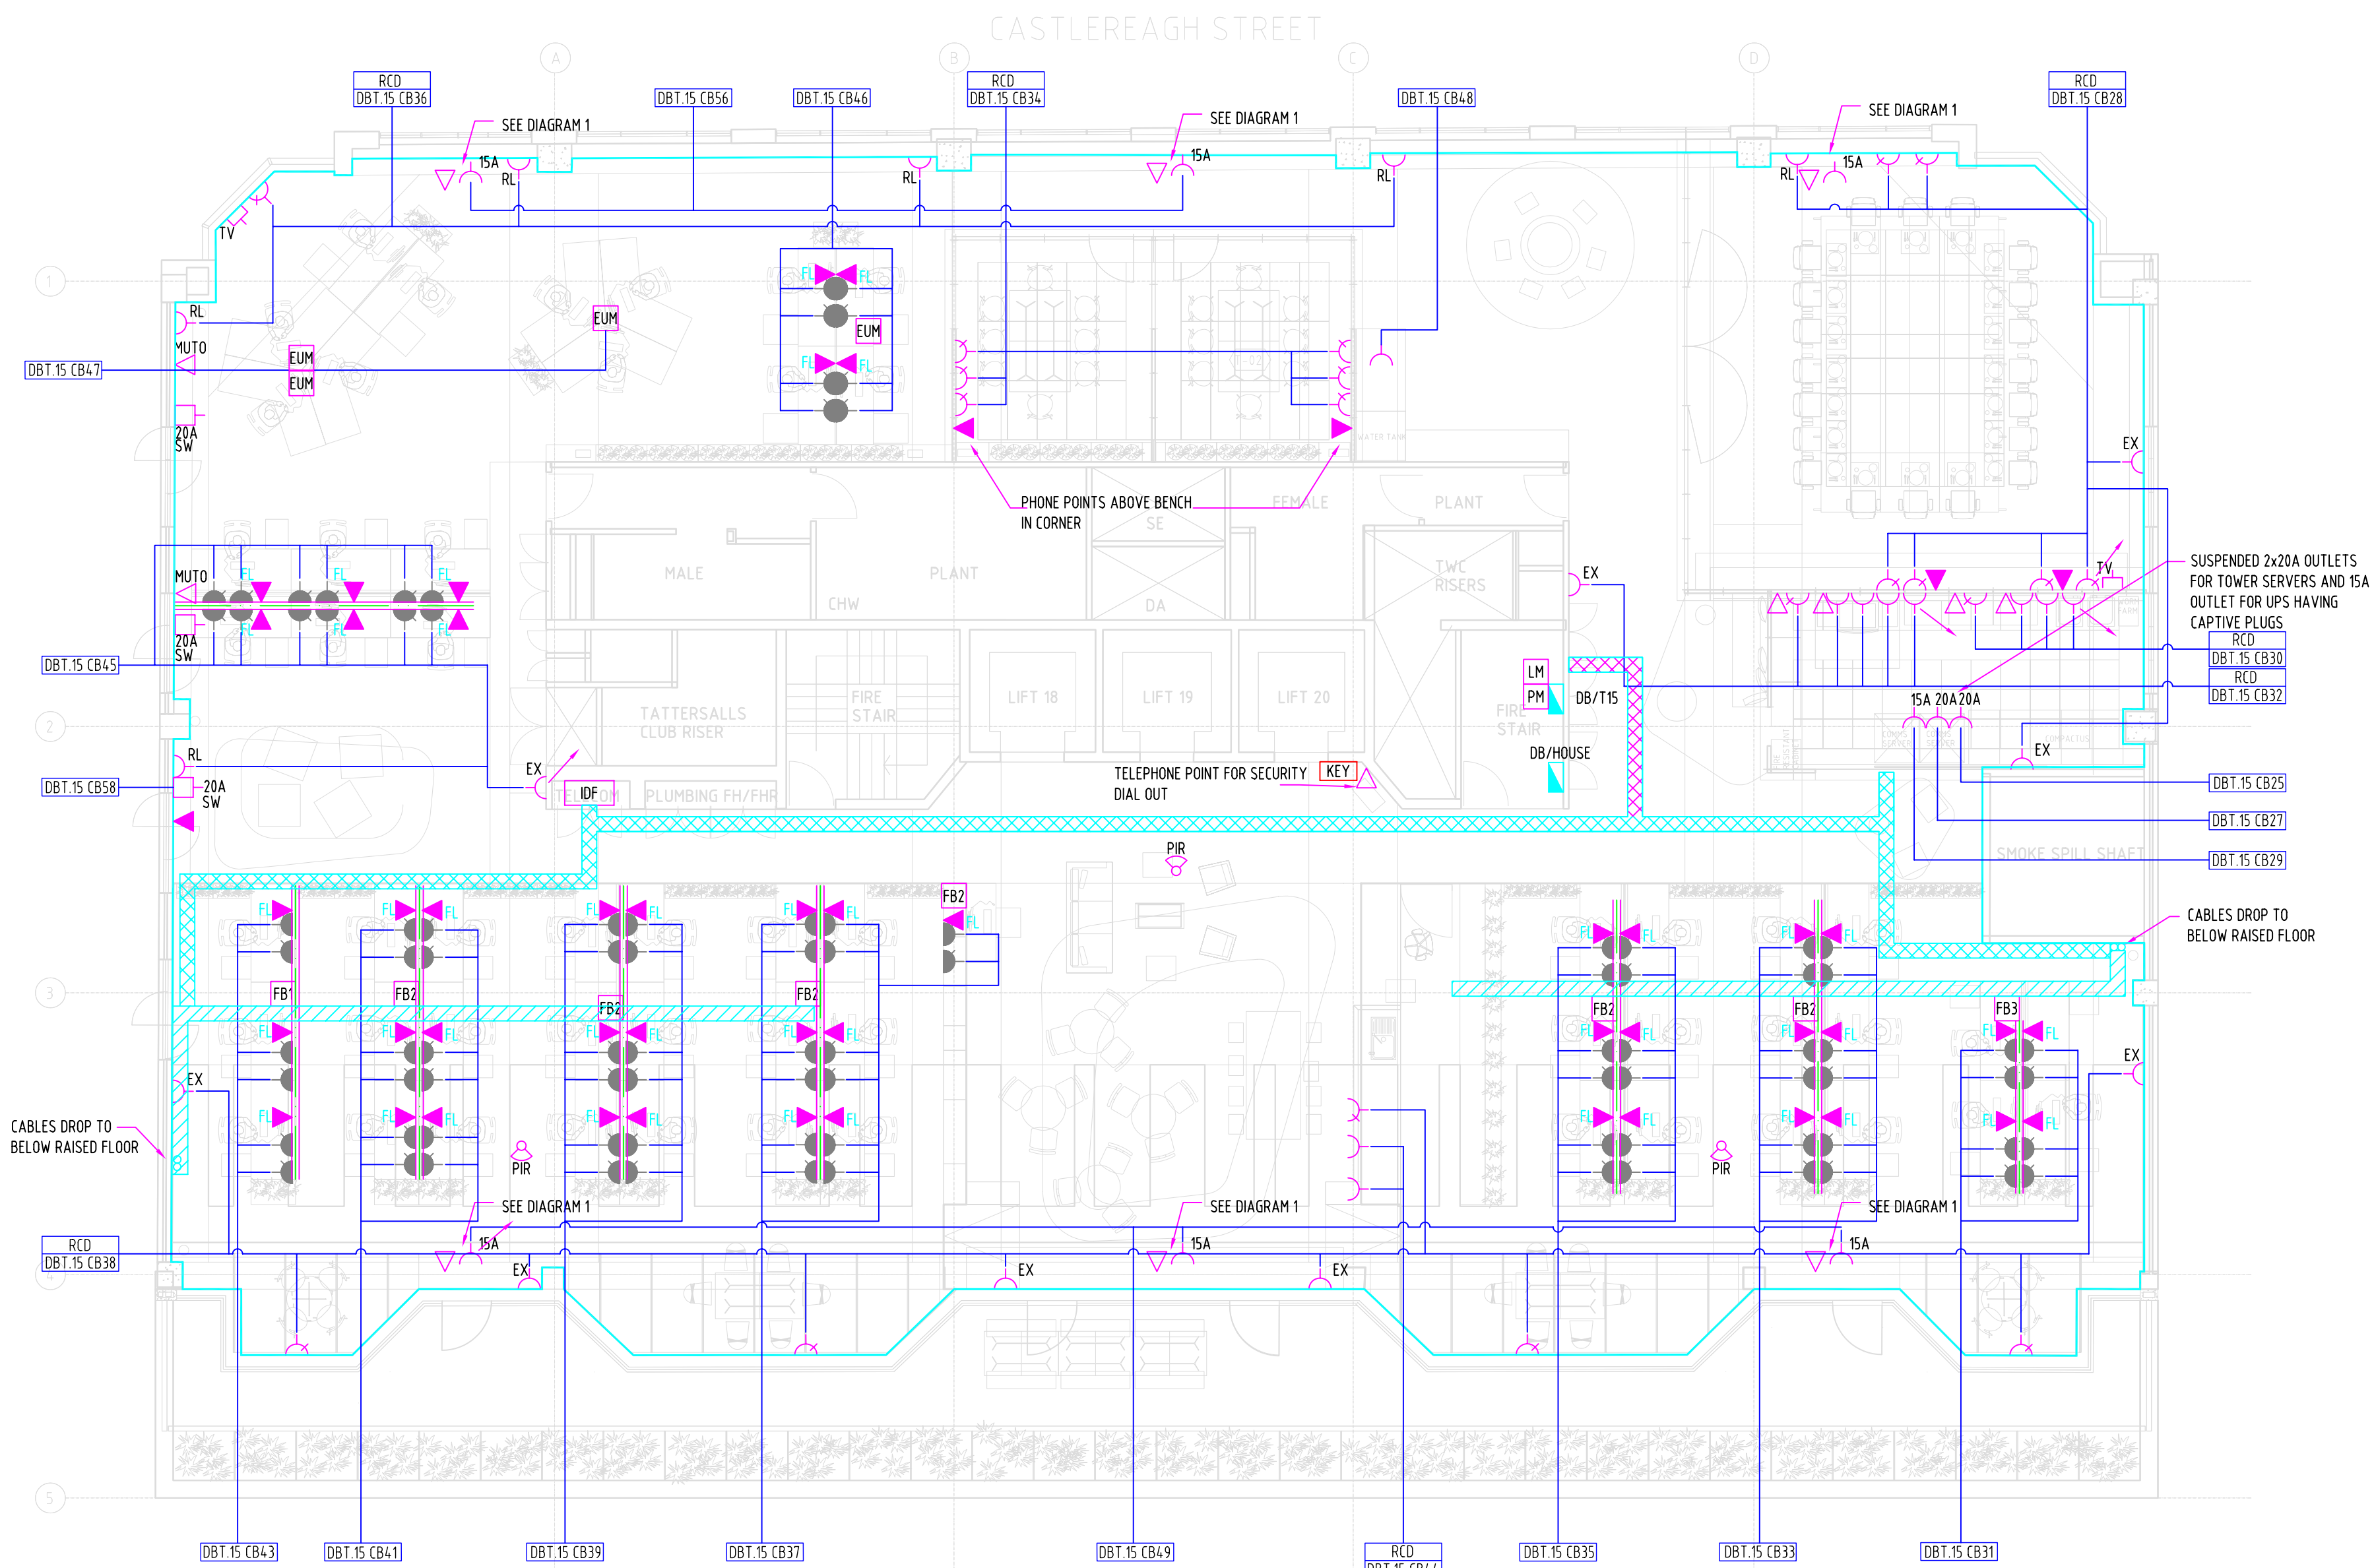

- FB1 FLOOR BOX CONTAINS - 1 X 20A
3 X DOUBLE RJ45
- FB2 FLOOR BOX CONTAINS - 1 X 20A
6 X DOUBLE RJ45
- FB3 FLOOR BOX CONTAINS - 1 X 20A
4 X DOUBLE RJ45
- EUM UMBILICAL - OUTLETS MOUNTED AT HL WITH DROPPERS TO FLOOR LEVEL
1 X 20A
6 X DOUBLE RJ45
- 10A DGPO
EX - EXISTING TO BE RETAINED
RL - EXISTING TO BE RELOCATED TO FRONT OF PLENUM WHERE NEEDED
- SOFT WIRED 10A DGPO
- STARTER SOCKET
- SINGLE RJ45
FL - DENOTES FLY LEAD
- DOUBLE RJ45
FL - DENOTES FLY LEAD
- MUTO MULTI USER COMMUNICATIONS OUTLET
12No RJ45 OUTLETS
- CABLE TRAY AT HIGH LEVEL 300mm
POWER AND 300mm COMMS
- CABLE TRAY BELOW RAISED FLOOR
300mm POWER AND 300mm COMMS
- CABLE DROPPERS
- 2 X 50mm BASKET STACKED 1 FOR
SOFT WIRE POWER AND 1 FOR COMMS
FLY LEADS
- PIR PIR INTRUDER DETECTOR
- KEY INTRUDER ALARM KEY PAD
- LM 100amp Three Phase meter for Lighting Circuits
Located in DB/T15
- PM 100amp Three Phase meter for power circuits
Located in DB/T15

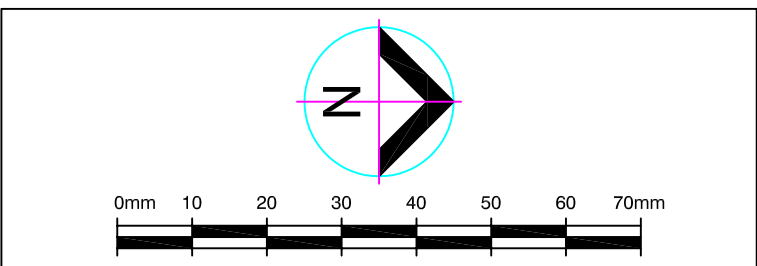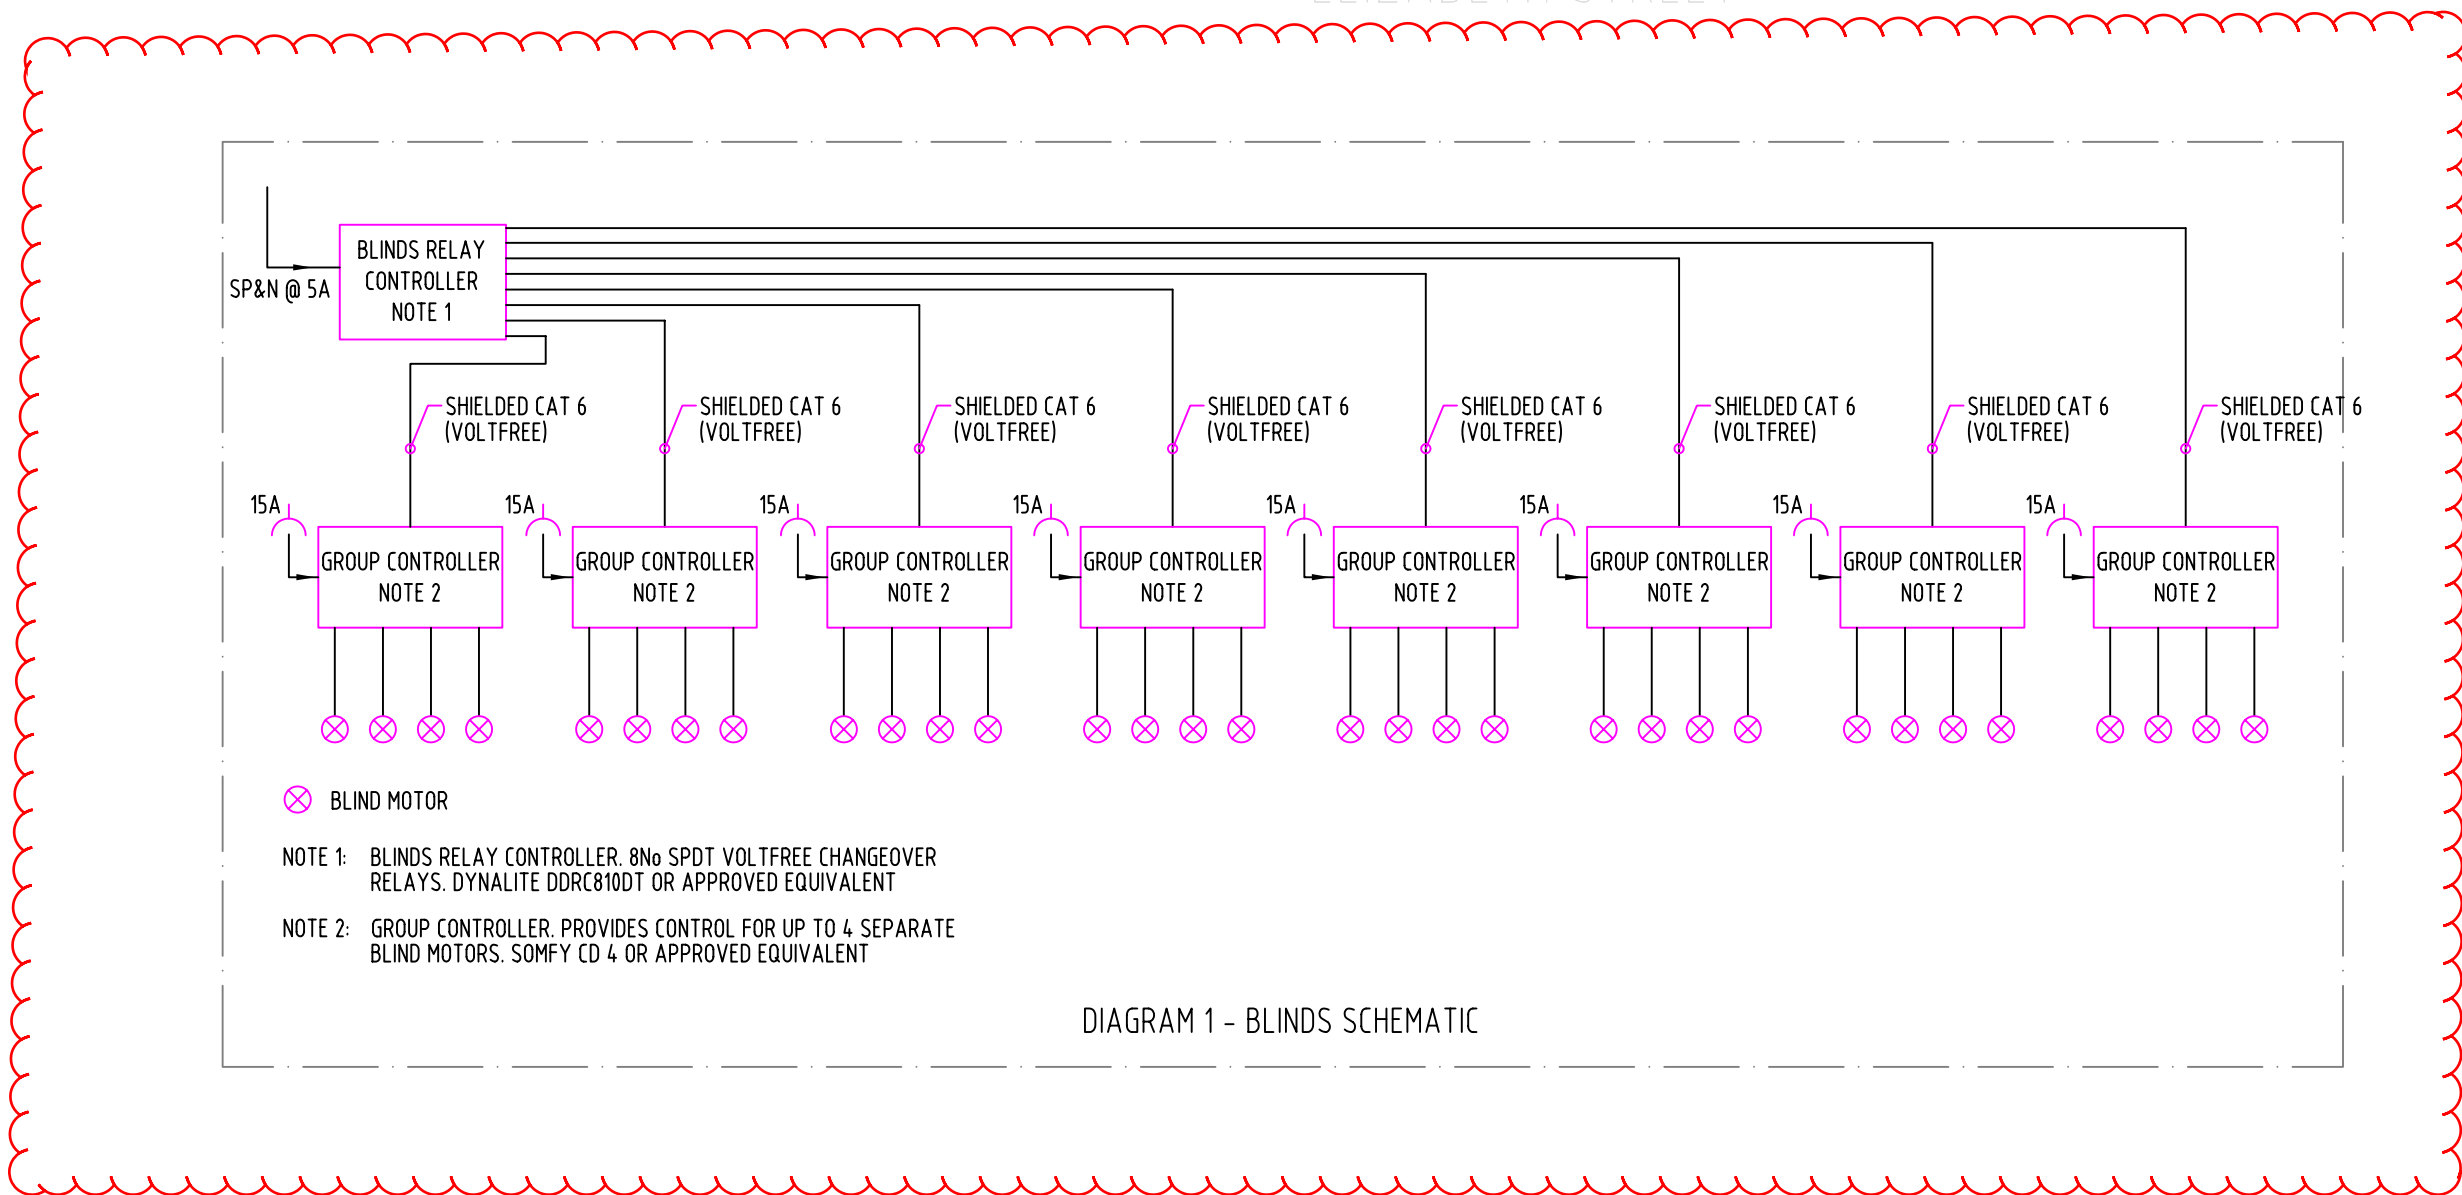




ELECTRICAL DATA COMMUNICATIONS

Unit 1, 9-11 Chaplin Drive
Lane Cove NSW 2066

Phone: + 61 2 9422 4444
Fax: + 61 2 9422 4400



Consulting Engineers

Auckland Auckland Bangkok
Brisbane Cairns Honolulu
Melbourne Perth Shanghai
Singapore Sydney

Level 1 41 McLaren Street
PO Box 6245 North Sydney
New South Wales 2060 Australia
Telephone 61 2 8957 0900
Facsimile 61 2 8957 4127
sydney@lincolnescott.com

PROJECT

LEVEL 15
179 ELIZABETH STREET
SYDNEY NSW 2000

CLIENT
GBCA

| | | | |
|------------|----------|----------|-----|
| DATE | 15.10.07 | DRAWN | MPB |
| SCALE | 1:100 | CHECKED | ASD |
| SHEET SIZE | A1 | APPROVED | ASD |
| CAD FILE | | | |

TITLE
ELECTRICAL SERVICES
POWER LAYOUT

PROJECT NO.
SYD 0703900 E002

DRAWING NO.
E002

REVISION
E

AS INSTALLED

FABRIC INFORMATION



Flame Retardant

SEMI TRANSPARENT - Metallised Screen

SYSTEMS AVAILABLE



Roller Blinds




Panel Glide



Roman Blinds

Verosol[®]

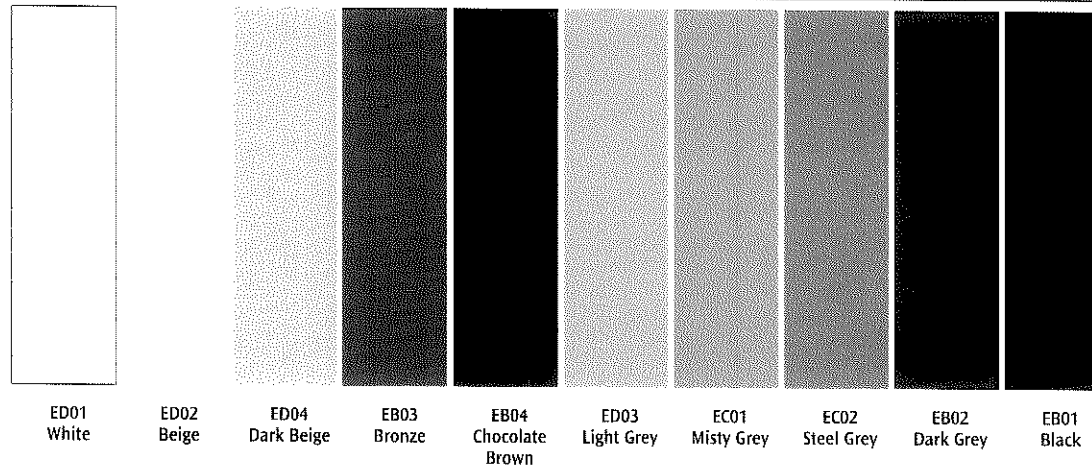SILVERSCREEN[™] - COLOUR RANGE

Verosol offers a premium range of competitive blinds and can provide motorisation, technical assistance and prototype proposals while also servicing your needs, throughout Australia and internationally.

Verosol has developed expertise in the research and development of window treatment solutions. We have researched, developed and tested all our products for maximum performance.

Note: All colours are representative only. Please ask for a sample for accurate colour presentation.

FABRIC INFORMATION



Flame Retardant

SEMI TRANSPARENT - Metallised Screen

SYSTEMS AVAILABLE



Roller Blinds



Panel Glide



Roman Blinds

Verosol®

SILVERSCREEN™

SPECIFICATIONS

Integrated and thermal optical properties

| | |
|------------------------------|---------------|
| Fabric Density | SilverScreen™ |
| Fabric colour | Dark Grey |
| Solar transmittance | 5% |
| Solar reflectance outside | 76% |
| Solar absorbance | 19% |
| Luminous transmittance | 5% |
| Luminous reflectance outside | 74% |
| Luminous absorbance | 21% |
| UV transmittance | 5% |
| Openness factor (nominal) | 4% |
| Ra[Colour rendering index] | 99 |

Glazing Type

| | Single 3mm Clear Glass | Solar Control Glazing |
|---------------------|------------------------|-----------------------|
| Light transmittance | 5% | 5% |
| G-value | 20% | 14% |
| Shading coefficient | 23% | 16% |
| U-value (W/m²K) | 1.7 | 0.7 |

Composition

36% Fibreglass / 64% PVC

Pattern

Natté 1x2

Weight per m²

400g ± 5%

Thickness

0.5mm ± 5%

Dimensional stability / Breaking strength

| | |
|------|-----------------------|
| Warp | 150daN/5cm |
| Weft | 150daN/5cm elongation |

Tear resistance

ISO 4674 6á 10 daN

Resistance to fold

Mini 20 daN/5cm

Colour fastness to light

ISO 105-B02 7/8

Anti static

Fabric is anti-static

Organic Emissions [VOC]

Green Building Council of Australia - Green Star Office Interior Spec. < 0.5mg/m²/hr (7 days)

ASTM D5116-97

Total Volatile Organic Compound - Specific Area Emission Rate 0.05mg/m²/hr

Flame retardancy

Ignitability Index 18 Range [0-20]

AS/NZS 1530.3-1999

Spread of flame index 0 Range [0-10]

Heat evolved index 0 Range [0-10]



Smoke developed index 4 Range [0-10]



No Blind



Transparent

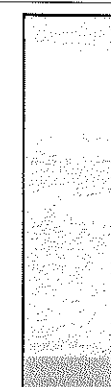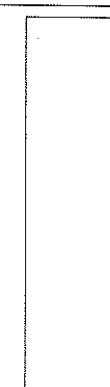Semi
TransparentNon
Transparent

Blockout

FEATURES

SilverScreen™ semi transparent metal backed screen fabric provides excellent vision out. SilverScreen™ dramatically reduces heat and glare at the window independent of colour. It is constructed from a hard wearing PVC coated fibreglass yarn and woven to 1900mm and 2400mm in width. SilverScreen™ is inherently flame retardant.

SilverScreen™ is designed specifically for manual and motorised roller blinds systems.




Note: All presented data calculated in WIS 3.0.1 (Advanced Windows Information System) with spectral data. Specifications and other data are based on information available at the time of preparation of this document and are subject to production tolerances and/or change without prior notice. Flame retardancy information is sourced from AWTA testing results. Please note that test results may vary slightly depending on fabric colour. [Solar Control Glazing EN 13363-2, ISO 15099, Measurements according to EN410], [3mm Single Glass(Pilkington OpCL_3.plg) according to EN410, ISO 9050 and ISO 15099 without ventilation].

FABRICS AVAILABLE


809, 812, 816, 875, SilverScreen™, Veroscreen, Veropaque, Veroluscent, Veroflock, Veroblock, Illusion, Mirage, Ultra, Europa, Lumiere, Satin

Verosol®


AMBIENCE MULTI-LINK ROLLER SYSTEM

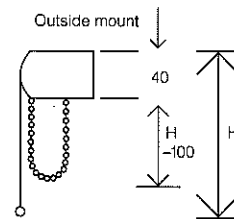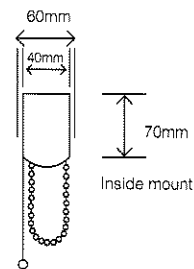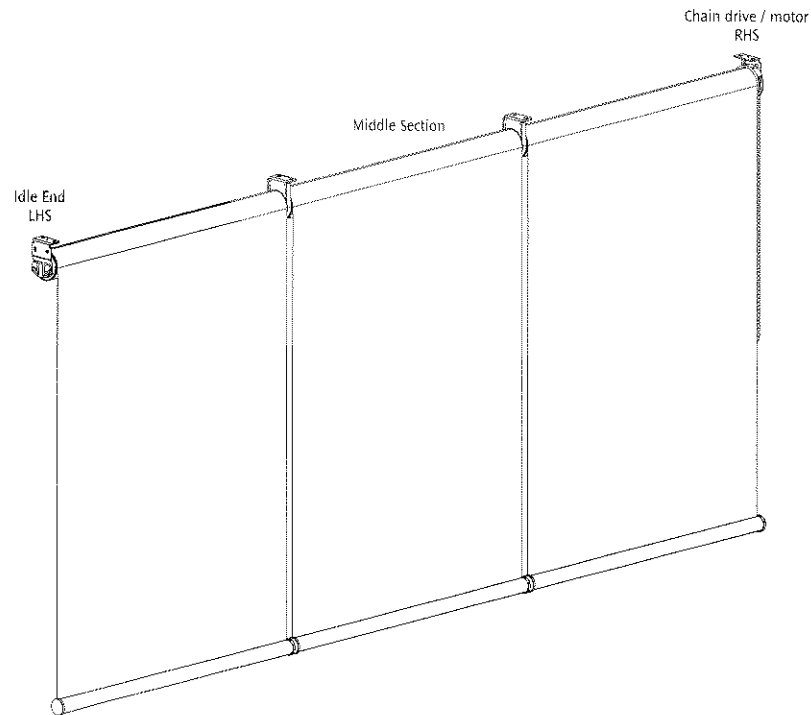

Optional Headbox

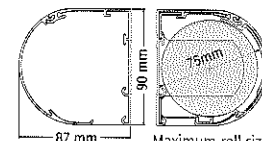

Maximum roll size:
75mm diameter

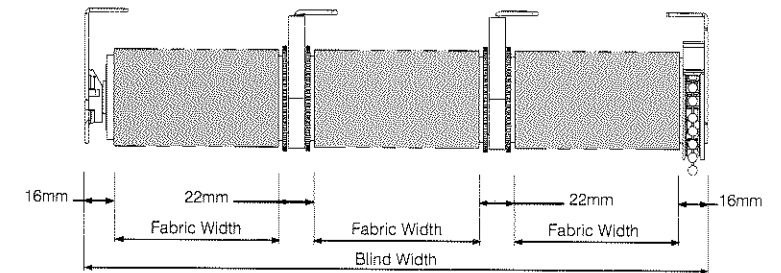


FEATURES

Operate multiple blinds for larger window spans with a single chain, eliminating unsightly cords. The result is better light control, greater privacy, uninterrupted views, and indoor/outdoor accessibility. The system is also available as motorised, with one tubular motor driving multiple sections. Can be easily upgraded from chain to motorised at any time. Optional cassette style headbox is also available.

Verosol®

SPECIFICATIONS

AMBIENCE MULTI-LINK ROLLER SYSTEM

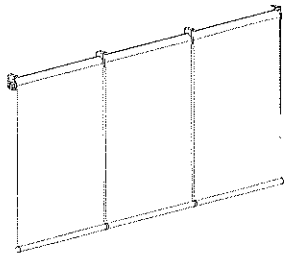

| | | |
|-----------------|--------------------------------|---|
| Available sizes | Subject to material roll width | Width to drop ratio: 1:3 or less |
| | Width | 2400 mm Maximum – 500mm Minimum |
| | Drop | 3000 mm Maximum – 500mm Minimum |
| Fabric | Maximum area | 15m2 (max.3 sections) – Chain Drive system |
| | Maximum area | 24m2 (max.4 sections) – Motoerised system |
| Top roller | Material | Extruded aluminium roller tube |
| | Diameter | 43mm |
| | Wall thickness | 1.25mm |
| Bottom rail | Material | Extruded aluminium alloy |
| | Diametre | 21mm |
| | Wall thickness | 0.8mm |
| | Colour | White, Black, Grey, White Birch and Clear Anodised aluminium |
| Control | Type | Chain Drive |
| | Mechanism | Direct action dual reverse clutch wound spring which operates in such a way that it only applies the precise braking power necessary to keep the blind in the desired position. |
| | Intermediate | Female drive unit and male receiver, with nylon retractable spindles and clear PC control wheel |
| | Idler | Spring pin idler end for easy installation. The idler end mechanism also incorporates a quick release system which allows easy removal of the blind. |
| | Colour | White, Black, Grey, White Birch |
| Control chain | Material | PVC or Nickel plated Steel |
| | Colour | White, Black, Grey, White Birch in PVC, Silver in nickel plated steel |

| | | |
|------------------|---|---|
| Brackets | Material | Press formed steel, pre-treated and powder coated |
| | Options | Top or Face fixing; Left or Right Control |
| | Colour | White, Black, Grey, White Birch |
| | Paint | Electrostatic powder coated and baked |
| Plastic Cover | Material | Acetal Compound and masterbatch |
| Motorisation | 240V AC | 40mm tubular motor mounted internally within a 43mm aluminium tube. The motor is complete with in built limit switches and a variety of control options available including radio remote control. |
| | | |
| Optional Headbox | Type | Two piece cassette style |
| | Material | Extruded aluminium alloy [T5 Temper] |
| | Wall Thickness | 2.0mm |
| | Dimensions | 87mm (depth) x 90mm (height) |
| | Colour | White, Black, Grey, White Birch, and Clear Anodised Aluminium |
| Important Note: | Fixing | Top or Face |
| | Maximum Width in one length of Headbox is 4.8mtrs | |



06 March 2009

Joe Karten
Green Building Council of Australia
Level 15, 179 Elizabeth St
Sydney, NSW 2000

Dear Joe,

Following the final programming and commissioning of all lighting and blinds in the GBCA Sydney Office fitout at 179 Elizabeth Street, I confirm the following:

- Board Room default lighting levels are at a 320-400 LUX average – and lighting controls reset to these levels (or off) when video conferencing equipment is not in operation.
- The lighting has been grouped into the zones called out on the E001 Lighting plan produced by KLM and no zone exceeds 100m².
- Switching for task based lighting at workstations is controlled via staff computers at the location. Switching for general lighting is controlled via the touch screen near reception. Switching for circulation lighting controlled via PIR and photo-electric sensors. Switching for meeting room lighting is controlled via PIR and through a manual override switch in each meeting room.
- Window blinds have been programmed for full automation with manual override function controllable from the touch screen near reception and from within the Board Room for Board Room window blinds.

The lighting has been fully programmed and commissioned in accordance with the GBCA Fitout Lighting Control document produced by Vision Design.

Feel free to contact me with any further queries you may have.

Kind regards,
Joseph Gebaily
Technical Leader NSW Commissioning



Unit 6, 691 Gardeners Road Mascot NSW 2020 Australia
t +61 2 8338 9899 • d +61 2 9019 8845 • m +61 419 748 847 • f +61 2 9019 8899
joe.gebaily@dynalite.com.au • dynalite-online.com

Verosol®

Verosol Australia Pty Ltd

ABN 36 006 221 003
2 Garema Circuit
Kingsgrove NSW 2208
PO Box 426
Kingsgrove NSW 1480
T: (612) 97844141
F: (612) 9750 8813-Marketing
E: information@verosol.com.au
I: www.verosol.com.au

Thursday 17th January 2008

Attention: Adam Terrill
Schiavello Project Interiors
Email: aterrill@schiaavello.com.au
Phone: 03 9674 1553
Fax: 03 9674 1666
Mobile: 0407 322 346
Subject: GBCA Project
Re: Deposit Required

Proforma Tax Invoice: GBCA 170108R

Before proceeding with the production of blinds required for GBCA Project we will require a 50% deposit.

Amount required is [REDACTED] this is inclusive of GST.

The balance will be required on completion of Installation.

Total Invoice value is [REDACTED] this is inclusive of GST.

APPROVED

DATE 18/1/08

Regards,

Verosol Australia PTY LTD

Schiavello

Schiavello Project Interiors Pty Ltd

Schiavello Project Interiors Pty Ltd ABN 94 119 954 399
 31-49 Queensbridge Street Southbank Melbourne Victoria 3006 Australia
 Private Bag 2 Tullamarine Melbourne Victoria 3043 Australia
 T 613 9674 1600 F 613 9674 1666

Order number

195

Order

Please supply to our account the goods listed below, subject to the condition at the bottom and the back of this order.

Name and address VEROSOL AUSTRALIA.
2 GARDMA CIRCLE
KINGSBROVE NSW 2208
ATT: BRETT ANNESLEY

Date of issue

1/11/2007

Job number SSNC 07VLO26700
 Job name/head contract GBCA - SYDNEY

SUPPLY DELIVER INSTALL & COMMISSION

68' ROLLER BLINDS

- 43mm AMBIENCE MOTORIZED BLINDS
- MOTORIZED MULTI LINK & UNIT JUNT BLIND SYSTEM
- CONTROLLERS TO SUIT BMS
- FABRIC OLIVER SCREEN

COST

GST

TOTAL \$

SITE CONTACTS

17/1/06 IN 170100R

Authority

ADAM TERRELL 1/11/07 0407 322346

Deliver to

LVL 15 - 170 ELIZABETH ST, SYDNEY

Schedule date

19TH DEC 2007

ORR APPROVED

Main conditions and terms on reverse. We reserve the right to cancel this Order or any part thereof in the event of any variation of the requirements set down in this Order. Order Number to be quoted on all delivery dockets and invoices. All invoices to be submitted promptly to the above address in duplicate.

Verosol (Australia) Pty Ltd
P.O. Box 426
Kingsgrove
1480
ABN-36 006 221 003
(02) 9784 4141

Customer's..TAX INVOICE 183362

Date 13/ 3/2008
Q.A.P. form 2.15.9

ACCOUNT NAME (515)

Accounts' customer

Schiavello Project Int P/L
Private Bag 2
Tullamarine VIC 3043

GBCA
L15 179 ELIZABETH ST
SYDNEY
0000

| Product (13) | Works No | Tax Exemption | GST Amnt | Order number |
|-------------------|----------|---------------|----------|--------------|
| MOTORISED ROLLERS | W20603 | | | |

| Colour | Description | Qty | List | Wdth | Drop | Price |
|--------|-------------|-----|------|------|------|-------|
|--------|-------------|-----|------|------|------|-------|

FOR THE SUPPLY & INSTALLATION
OF MOTORISED ROLLER BLIND

APPROVED *[Signature]*
DATE *3/4/08*

ENTERED

Total of above
TOTAL AMOUNT DUE including GST >

Goods remain the property of Verosol (Australia) Pty Ltd until full invoice payment is made. Verosol (Australia) Pty Ltd reserves the right to recover possession of the goods if not paid in full.

Please return with your payment

From: *Schiavello Project Int P/L*
Private Bag 2
Tullamarine VIC 3043

Trading terms :-C.O.D.

| | | | | |
|---------------------|---------------------|---------------------|---------------------|---------------------|
| ADELAIDE | BRISBANE | MELBOURNE | SYDNEY | PERTH |
| Tel: (08) 8224 0122 | Tel: (07) 3274 4911 | Tel: (03) 9328 2322 | Tel: (02) 9784 4141 | Tel: (08) 9228 2622 |
| Fax: (08) 8224 0411 | Fax: (07) 3274 4899 | Fax: (03) 9328 2383 | Fax: (02) 9750 3111 | Fax: (08) 9228 2627 |

Verosol (Australia) Pty Ltd
P.O. Box 426
Kingsgrove
1480
ABN-36 006 221 003
(02) 9784 4141

Customer's..TAX INVOICE 183363

Date 13/ 3/2008
Q.A.P. form 2.15.9

ACCOUNT NAME (515)

Accounts' customer

Schiavello Project Int P/L
Private Bag 2
Tullamarine VIC 3043

GBCA
L15 179 ELIZABETH ST
SYDNEY
0000

| | | | | |
|-------------------|----------|---------------|----------|--------------|
| Product (13) | Works No | Tax Exemption | GST Amnt | Order number |
| MOTORISED ROLLERS | W20605 | | | |

| | | | | | | |
|--------|-------------|-----|------|------|------|-------|
| Colour | Description | Qty | List | Wdth | Drop | Price |
|--------|-------------|-----|------|------|------|-------|

FOR THE SUPPLY & INSTALLATION
OF MOTORISED ROLLER BLINDS

APPROVED *[Signature]*

DATE *3/4/08*

ENTERED *[Stamp]*

Less allowance of 5.00%

Total of ab
TOTAL AMOUNT DUE including GS

Goods remain the property of Verosol (Australia) Pty Ltd until full invoice payment is made. Verosol (Australia) Pty Ltd reserves the right to recover possession of the goods if not paid in full.

Please return with your payment

From: *Schiavello Project Int P/L*
Private Bag 2
Tullamarine VIC 3043

Trading terms :-C.O.D.

| | | | | |
|---------------------|---------------------|---------------------|---------------------|---------------------|
| ADELAIDE | BRISBANE | MELBOURNE | SYDNEY | PERTH |
| Tel: (08) 8224 0122 | Tel: (07) 3274 4911 | Tel: (03) 9328 2322 | Tel: (02) 9784 4141 | Tel: (08) 9228 2622 |
| Fax: (08) 8224 0411 | Fax: (07) 3274 4899 | Fax: (03) 9328 2383 | Fax: (02) 9750 3111 | Fax: (08) 9228 2627 |

Verosol (Australia) Pty Ltd
P.O. Box 426
Kingsgrove
1480
ABN-36 006 221 003
(02) 9784 4141

Customer's..TAX INVOICE 183364

Date 13/ 3/2008
Q.A.P. form 2.15.9

ACCOUNT NAME (515)

Accounts' customer

*Schiavello Project Int P/L
Private Bag 2
Tullamarine VIC 3043*

GBCA
L15 179 ELIZABETH ST
SYDNEY
0000

| Product (9) | Works No | Tax Exemption | GST Amnt | Order number |
|------------------|----------|---------------|----------|--------------|
| AMBIENCE ROLLERS | W20606 | | | |

| Colour | Description | Qty | List | Wdth | Drop | Price |
|--------|-------------|-----|------|------|------|-------|
|--------|-------------|-----|------|------|------|-------|

Y

FOR THE SUPPLY & INSTALLATION
OF ONE VEROSOL ROLLER BLIND

APPROVED

DATE

[Signature]
3/4/08

ENTERED

Less allowance of 5.00%

Total of above
TOTAL AMOUNT DUE including GST >

Goods remain the property of Verosol (Australia) Pty Ltd until full invoice payment is made. Verosol (Australia) Pty Ltd reserves the right to recover possession of the goods if not paid in full.

Please return with your payment

From: *Schiavello Project Int P/L
Private Bag 2
Tullamarine VIC 3043*

Invoice No
Date.....
Account Nu
AMOUNT DUE

Trading terms :-C.O.D.

ADELAIDE
Tel: (08) 8224 0122
Fax: (08) 8224 0411

BRISBANE
Tel: (07) 3274 4911
Fax: (07) 3274 4899

MELBOURNE
Tel: (03) 9328 2322
Fax: (03) 9328 2383

SYDNEY
Tel: (02) 9784 4141
Fax: (02) 9750 3111

PERTH
Tel: (08) 9228 2622
Fax: (08) 9228 2627

Verosol (Australia) Pty Ltd
P.O. Box 426
Kingsgrove
1480
ABN-36 006 221 003
(02) 9784 4141

Customer's..TAX INVOICE 183365

Date 13/ 3/2008
Q.A.P. form 2.15.9

ACCOUNT NAME (515)

Accounts' customer

Schiavello Project Int P/L
Private Bag 2
Tullamarine VIC 3043

GBCA
L15 179 ELIZABETH ST
SYDNEY
0000

| Product (13) | Works No | Tax Exemption | GST Amnt | Order number |
|-------------------|----------|---------------|----------|--------------|
| MOTORISED ROLLERS | W20607 | | | |

| Colour | Description | Qnty | List | Wdth | Drop | Price |
|--------|-------------|------|------|------|------|-------|
|--------|-------------|------|------|------|------|-------|

FOR THE SUPPLY & INSTALLATION
OF SIX MOTORISED ROLLER BLINDS

APPROVED 

DATE 3/4/08

ENTERED

Less allowance of 5.00%

Total of above
TOTAL AMOUNT DUE including GST >

Goods remain the property of Verosol (Australia) Pty Ltd until full invoice payment is made. Verosol (Australia) Pty Ltd reserves the right to recover possession of the goods if not paid in full.

Please return with your payment

From: *Schiavello Project Int P/L*
Private Bag 2
Tullamarine VIC 3043

Invoice No.
Date.....
Account Num
AMOUNT DUE.

Trading terms :-C.O.D.

ADELAIDE
Tel: (08) 8224 0122
Fax: (08) 8224 0411

BRISBANE
Tel: (07) 3274 4911
Fax: (07) 3274 4899

MELBOURNE
Tel: (03) 9328 2322
Fax: (03) 9328 2383

SYDNEY
Tel: (02) 9784 4141
Fax: (02) 9750 3111

PERTH
Tel: (08) 9228 2622
Fax: (08) 9228 2627

Verosol (Australia) Pty Ltd
P.O. Box 426
Kingsgrove
1480

ABN-36 006 221 003
(02) 9784 4141

ACCOUNT NAME (515)

Schiavello Project Int P/L
Private Bag 2
Tullamarine VIC 3043

Customer's..TAX INVOICE 183366

Date 13/ 3/2008

Q.A.P. form 2.15.9

Accounts' customer

GBCA-LEVEL 15
179 ELIZABETH ST
SYDNEY
0000

| Product (9) | Works No | Tax Exemption | GST Amnt | Order number |
|------------------|----------|---------------|----------|--------------|
| AMBIENCE ROLLERS | W20627 | | | |

| Colour | Description | Qnty | List | Wdth | Drop | Price |
|--------|-------------|------|------|------|------|-------|
|--------|-------------|------|------|------|------|-------|

FOR THS SUPPLY & INSTALLATION
OF TWO AMBIENCE ROLLER BLINDS

APPROVED *[Signature]*

DATE *3/4/08*

ENTERED

Less allowance of 5.00%

Total of above

TOTAL AMOUNT DUE including GST >

Goods remain the property of Verosol (Australia) Pty Ltd until full invoice payment is made. Verosol (Australia) Pty Ltd reserves the right to recover possession of the goods if not paid in full.

Please return with your payment

From: *Schiavello Project Int P/L*
Private Bag 2
Tullamarine VIC 3043

Trading terms :-C.O.D.

ADELAIDE
Tel: (08) 8224 0122
Fax: (08) 8224 0411

BRISBANE
Tel: (07) 3274 4911
Fax: (07) 3274 4899

MELBOURNE
Tel: (03) 9328 2322
Fax: (03) 9328 2383

SYDNEY
Tel: (02) 9784 4141
Fax: (02) 9750 3111

PERTH
Tel: (08) 9228 2622
Fax: (08) 9228 2627

Verosol (Australia) Pty Ltd
P.O. Box 426
Kingsgrove
1480
ABN-36 006 221 003
(02) 9784 4141

Customer's..TAX INVOICE 183367

Date 13/ 3/2008
Q.A.P. form 2.15.9

ACCOUNT NAME (515)

Accounts' customer

*Schiavello Project Int P/L
Private Bag 2
Tullamarine VIC 3043*

GBCA-LEVEL 15
179 ELIZABETH ST
SYDNEY
0000

| Product (13) | Works No | Tax Exemption | GST Amnt | Order number |
|-------------------|----------|---------------|----------|--------------|
| MOTORISED ROLLERS | W20628 | | | |

| Colour | Description | Qnty | List | Wdth | Drop | Price |
|--------|-------------|------|------|------|------|-------|
|--------|-------------|------|------|------|------|-------|

FOR THS SUPPLY & INSTALLATION
OF FOUR VEROSOL MOTORISED
ROLLER BLINDS

APPROVED

DATE

3/4/08

ENTERED

Less allowance of 5.00%

Total of above
TOTAL AMOUNT DUE including GST >

Goods remain the property of Verosol (Australia) Pty Ltd until full invoice payment is made. Verosol (Australia) Pty Ltd reserves the right to recover possession of the goods if not paid in full.

Please return with your payment

From: *Schiavello Project Int P/L
Private Bag 2
Tullamarine VIC 3043*

Trading terms :-C.O.D.

ADELAIDE
Tel: (08) 8224 0122
Fax: (08) 8224 0411

BRISBANE
Tel: (07) 3274 4911
Fax: (07) 3274 4899

MELBOURNE
Tel: (03) 9328 2322
Fax: (03) 9328 2383

SYDNEY
Tel: (02) 9784 4141
Fax: (02) 9750 3111

PERTH
Tel: (08) 9228 2622
Fax: (08) 9228 2627

Verosol (Australia) Pty Ltd
P.O. Box 426
Kingsgrove
1480
ABN-36 006 221 003
(02) 9784 4141

Customer's..TAX INVOICE 183368

Date 13/ 3/2008
Q.A.P. form 2.15.9

ACCOUNT NAME (515)

Accounts' customer

*Schiavello Project Int P/L
Private Bag 2
Tullamarine VIC 3043*

GBCA-LEVEL 15
179 ELIZABETH ST
SYDNEY
0000

| Product (13) | Works No | Tax Exemption | GST Amnt | Order number |
|-------------------|----------|---------------|----------|--------------|
| MOTORISED ROLLERS | W20629 | | | |

| Colour | Description | Qty | List | Width | Drop | Price |
|--------|-------------|-----|------|-------|------|-------|
|--------|-------------|-----|------|-------|------|-------|

FOR THE SUPPLY & INSTALLATION
OF SIX VEROSOL MOTORISED
ROLLER BLINDS

APPROVED

DATE

[Signature]
34/09

ENTERED

Less allowance of 5.00%

Total of above
TOTAL AMOUNT DUE including GST >

Goods remain the property of Verosol (Australia) Pty Ltd until full invoice payment is made. Verosol (Australia) Pty Ltd reserves the right to recover possession of the goods if not paid in full.

Please return with your payment

From: *Schiavello Project Int P/L
Private Bag 2
Tullamarine VIC 3043*

Trading terms :-C.O.D.

ADELAIDE
Tel: (08) 8224 0122
Fax: (08) 8224 0411

BRISBANE
Tel: (07) 3274 4911
Fax: (07) 3274 4899

MELBOURNE
Tel: (03) 9328 2322
Fax: (03) 9328 2383

SYDNEY
Tel: (02) 9784 4141
Fax: (02) 9750 3111

PERTH
Tel: (08) 9228 2622
Fax: (08) 9228 2627

Verosol (Australia) Pty Ltd
P.O. Box 426
Kingsgrove
1480
ABN-36 006 221 003
(02) 9784 4141

Customer's..TAX INVOICE 183369

Date 13/ 3/2008
Q.A.P. form 2.15.9

ACCOUNT NAME (515)

Accounts' customer

Schiavello Project Int P/L
Private Bag 2
Tullamarine VIC 3043

GBCA-LEVEL 15
179 ELIZABETH ST
SYDNEY
0000

| Product (9) | Works No | Tax Exemption | GST Amnt | Order number |
|------------------|----------|---------------|----------|--------------|
| AMBIENCE ROLLERS | W20630 | | | |

| Colour | Description | Qty | List | Wdth | Drop | Price |
|--------|-------------|-----|------|------|------|-------|
|--------|-------------|-----|------|------|------|-------|

FOR THE SUPPLY & INSTALLATION
OF ONE VEROSOL ROLLER BLIND

APPROVED

DATE 3/4/08

ENTERED

Less allowance of 5.00%

Total of above
TOTAL AMOUNT DUE including GST >

Goods remain the property of Verosol (Australia) Pty Ltd until full invoice payment is made. Verosol (Australia) Pty Ltd reserves the right to recover possession of the goods if not paid in full.

Please return with your payment

From: *Schiavello Project Int P/L*
Private Bag 2
Tullamarine VIC 3043

Trading terms :-C.O.D.

ADELAIDE
Tel: (08) 8224 0122
Fax: (08) 8224 0411

BRISBANE
Tel: (07) 3274 4911
Fax: (07) 3274 4899

MELBOURNE
Tel: (03) 9328 2322
Fax: (03) 9328 2383

SYDNEY
Tel: (02) 9784 4141
Fax: (02) 9750 3111

PERTH
Tel: (08) 9228 2622
Fax: (08) 9228 2627

Verosol (Australia) Pty Ltd
P.O. Box 426
Kingsgrove
1480
ABN-36 006 221 003
(02) 9784 4141

Customer's..TAX INVOICE 183370

Date 13/ 3/2008
Q.A.P. form 2.15.9

ACCOUNT NAME (515)

Accounts' customer

Schiavello Project Int P/L
Private Bag 2
Tullamarine VIC 3043

GBCA-LEVEL 15
179 ELIZABETH ST
SYDNEY
0000

| | | | | |
|-------------------|----------|---------------|----------|--------------|
| Product (13) | Works No | Tax Exemption | GST Amnt | Order number |
| MOTORISED ROLLERS | W20631 | | | |

| Colour | Description | Qty | List | Width | Drop | Price |
|--------|-------------|-----|------|-------|------|-------|
|--------|-------------|-----|------|-------|------|-------|

FOR THE SUPPLY & INSTALLATION
OF FIVE VEROSOL MOTORISED
ROLLER BLINDS

APPROVED *[Signature]*
DATE *3/4/08*

ENTERED

Less allowance of 5.00%

Total of above
TOTAL AMOUNT DUE including GST >

Goods remain the property of Verosol (Australia) Pty Ltd until full invoice payment is made. Verosol (Australia) Pty Ltd reserves the right to recover possession of the goods if not paid in full.

Please return with your payment

From: *Schiavello Project Int P/L*
Private Bag 2
Tullamarine VIC 3043

Trading terms :-C.O.D.

Verosol (Australia) Pty Ltd
P.O. Box 426
Kingsgrove
1480
ABN-36 006 221 003
(02) 9784 4141

Customer's..TAX INVOICE 183371

Date 13/ 3/2008
Q.A.P. form 2.15.9

ACCOUNT NAME (515)

Accounts' customer

Schiavello Project Int P/L
Private Bag 2
Tullamarine VIC 3043

GBCA-LEVEL 15
179 ELIZABETH ST
SYDNEY
0000

| Product (13) | Works No | Tax Exemption | GST Amnt | Order number |
|-------------------|----------|---------------|----------|--------------|
| MOTORISED ROLLERS | W20633 | | | |

| Colour | Description | Qty | List | Width | Drop | Price |
|--------|-------------|-----|------|-------|------|-------|
|--------|-------------|-----|------|-------|------|-------|

FOR THE SUPPLY & INSTALLATION
OF FOUR MOTORISED ROLLER
BLINDS

APPROVED

DATE

3/4/08

ENTERED

Less allowance of 5.00%

Total of above
TOTAL AMOUNT DUE including GST

Goods remain the property of Verosol (Australia) Pty Ltd until full invoice payment is made. Verosol (Australia) Pty Ltd reserves the right to recover possession of the goods if not paid in full.

Please return with your payment

From: *Schiavello Project Int P/L*
Private Bag 2
Tullamarine VIC 3043

Trading terms :-C.O.D.

| | | | | |
|---------------------|---------------------|---------------------|---------------------|---------------------|
| ADELAIDE | BRISBANE | MELBOURNE | SYDNEY | PERTH |
| Tel: (08) 8224 0122 | Tel: (07) 3274 4911 | Tel: (03) 9328 2322 | Tel: (02) 9784 4141 | Tel: (08) 9228 2622 |
| Fax: (08) 8224 0411 | Fax: (07) 3274 4899 | Fax: (03) 9328 2383 | Fax: (02) 9750 3111 | Fax: (08) 9228 2627 |

Verosol (Australia) Pty Ltd
P.O. Box 426
Kingsgrove
1480
ABN-36 006 221 003
(02) 9784 4141

Customer's..TAX INVOICE 183372

Date 13/ 3/2008
Q.A.P. form 2.15.9

ACCOUNT NAME (515)

Accounts' customer

*Schiavello Project Int p/L
Private Bag 2
Tullamarine vic 3043*

GBCA-LEVEL 15
179 ELIZABETH ST
SYDNEY
0000

| Product (13) | Works No | Tax Exemption | GST Amnt | Order number |
|-------------------|----------|---------------|----------|--------------|
| MOTORISED ROLLERS | W20635 | | | |

| Colour | Description | Qty | List | Wdth | Drop | Price |
|--------|-------------|-----|------|------|------|-------|
|--------|-------------|-----|------|------|------|-------|

✓

FOR THE SUPPLY & INSTALLATION
OF THREE MOTORISED ROLLER
BLINDS

ENTERED

APPROVED

DATE

3/4/08

Less allowance of 5.00%

Total of above
TOTAL AMOUNT DUE including GST

Goods remain the property of Verosol (Australia) Pty Ltd until full invoice payment is made. Verosol (Australia) Pty Ltd reserves the right to recover possession of the goods if not paid in full.

Please return with your payment

From: *Schiavello Project Int p/L
Private Bag 2
Tullamarine vic 3043*

Trading terms :-C.O.D.

| | | | | |
|---------------------|---------------------|---------------------|---------------------|---------------------|
| ADELAIDE | BRISBANE | MELBOURNE | SYDNEY | PERTH |
| Tel: (08) 8224 0122 | Tel: (07) 3274 4911 | Tel: (03) 9328 2322 | Tel: (02) 9784 4141 | Tel: (08) 9228 2622 |
| Fax: (08) 8224 0411 | Fax: (07) 3274 4899 | Fax: (03) 9328 2383 | Fax: (02) 9750 3111 | Fax: (08) 9228 2627 |

Verosol (Australia) Pty Ltd
P.O. Box 426
Kingsgrove
1480
ABN-36 006 221 003
(02) 9784 4141

Customer's..TAX INVOICE 183373

Date 13/ 3/2008
Q.A.P. form 2.15.9

ACCOUNT NAME (515)

Accounts' customer

Schiavello Project Int P/L
Private Bag 2
Tullamarine VIC 3043


GBCA-LEVEL 15
179 ELIZABETH ST
SYDNEY
0000

| | | | | |
|-------------------|----------|---------------|----------|--------------|
| Product (13) | Works No | Tax Exemption | GST Amnt | Order number |
| MOTORISED ROLLERS | W20637 | | | |

| | | | | | | |
|--------|-------------|-----|------|------|------|-------|
| Colour | Description | Qty | List | Wdth | Drop | Price |
|--------|-------------|-----|------|------|------|-------|

Y

FOR THE SUPPLY & INSTALLATION
OF NINE MOTORISED ROLLER
BLINDS

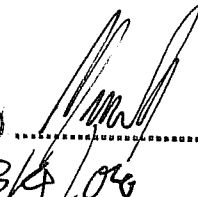APPROVED 
DATE 3/4/08

ENTERED

Less allowance of 5.00%

Total of above
TOTAL AMOUNT DUE including GST >

Goods remain the property of Verosol (Australia) Pty Ltd until full invoice payment is made. Verosol (Australia) Pty Ltd reserves the right to recover possession of the goods if not paid in full.

Please return with your payment

From: *Schiavello Project Int P/L*
Private Bag 2
Tullamarine VIC 3043

Trading terms :-C.O.D.

| | | | | |
|--|--|---|--|---|
| ADELAIDE Tel: (08) 8224 0122 Fax: (08) 8224 0411 | BRISBANE Tel: (07) 3274 4911 Fax: (07) 3274 4899 | MELBOURNE Tel: (03) 9328 2322 Fax: (03) 9328 2383 | SYDNEY Tel: (02) 9784 4141 Fax: (02) 9750 3111 | PERTH Tel: (08) 9228 2622 Fax: (08) 9228 2627 |
|--|--|---|--|---|

Verosol (Australia) Pty Ltd
P.O. Box 426
Kingsgrove
1480
ABN-36 006 221 003
(02) 9784 4141

Customer's..TAX INVOICE 183374

Date 13/ 3/2008
Q.A.P. form 2.15.9

ACCOUNT NAME (515)

Accounts' customer

Schiavello Project Int P/L
Private Bag 2
Tullamarine VIC 3043

GBCA-LEVEL 15
179 ELIZABETH ST
SYDNEY
0000

| | | | | |
|-----------------------------------|--------------------|---------------|---|--------------|
| Product (13) MOTORISED ROLLERS | Works No W20638 | Tax Exemption | GST Amnt <div style="background-color: black; width: 100px; height: 1.2em;"></div> | Order number |
|-----------------------------------|--------------------|---------------|---|--------------|

| | | | | | | |
|--------|-------------|-----|------|------|------|-------|
| Colour | Description | Qty | List | Wdth | Drop | Price |
|--------|-------------|-----|------|------|------|-------|

FOR THE SUPPLY & INSTALLATION
OF ELEVEN MOTORISED ROLLER
BLINDS

APPROVED *[Signature]*
DATE *3/4/08*

ENTERED

Less allowance of 5.00%

Total of above
TOTAL AMOUNT DUE including GST >

Goods remain the property of Verosol (Australia) Pty Ltd until full invoice payment is made. Verosol (Australia) Pty Ltd reserves the right to recover possession of the goods if not paid in full.

Please return with your payment

From: *Schiavello Project Int P/L*
Private Bag 2
Tullamarine VIC 3043

Trading terms :-C.O.D.

| | | | | |
|--|--|---|--|---|
| ADELAIDE Tel: (08) 8224 0122 Fax: (08) 8224 0411 | BRISBANE Tel: (07) 3274 4911 Fax: (07) 3274 4899 | MELBOURNE Tel: (03) 9328 2322 Fax: (03) 9328 2383 | SYDNEY Tel: (02) 9784 4141 Fax: (02) 9750 3111 | PERTH Tel: (08) 9228 2622 Fax: (08) 9228 2627 |
|--|--|---|--|---|

Verosol (Australia) Pty Ltd
P.O. Box 426
Kingsgrove
1480
ABN-36 006 221 003
(02) 9784 4141

Customer's..TAX INVOICE 183375

Date 13/ 3/2008
Q.A.P. form 2.15.9

ACCOUNT NAME (515)

Accounts' customer

Schiavello Project Int P/L
Private Bag 2
Tullamarine VIC 3043

GBCA-LEVEL 15
179 ELIZABETH ST
SYDNEY
0000

| | | | |
|-----------------------------------|--------------------|---------------|--------------|
| Product (13) MOTORISED ROLLERS | Works No W20643 | Tax Exemption | Order number |
|-----------------------------------|--------------------|---------------|--------------|

| | | | | | | |
|--------|-------------|-----|------|------|------|-------|
| Colour | Description | Qty | List | Wdth | Drop | Price |
|--------|-------------|-----|------|------|------|-------|

FOR THE SUPPLY & INSTALLATION
OF NINE MOTORISED ROLLER
BLINDS

APPROVED *[Signature]*
DATE *3/4/08*

ENTERED

 
Less allowance of 5.00%

Total of above
TOTAL AMOUNT DUE including GST >

Goods remain the property of Verosol (Australia) Pty Ltd until full invoice payment is made. Verosol (Australia) Pty Ltd reserves the right to recover possession of the goods if not paid in full.

Please return with your payment

From: *Schiavello Project Int P/L*
Private Bag 2
Tullamarine VIC 3043
Trading terms :-C.O.D.



Verosol (Australia) Pty Ltd
P.O. Box 426
Kingsgrove
1480
ABN-36 006 221 003
(02) 9784 4141

Customer's..TAX INVOICE 183376

Date 13/ 3/2008
Q.A.P. form 2.15.9

ACCOUNT NAME (515)

Accounts' customer

Schiavello Project Int P/L
Private Bag 2
Tullamarine VIC 3043

GBCA-LEVEL 15
179 ELIZABETH ST
SYDNEY
0000

| Product (13) | Works No | Tax Exemption | GST Amnt | Order number |
|-------------------|----------|---------------|----------|--------------|
| MOTORISED ROLLERS | W20645 | | | |

| Colour | Description | Qty | List | Wdth | Drop | Price |
|--------|-------------|-----|------|------|------|-------|
|--------|-------------|-----|------|------|------|-------|

FOR THE SUPPLY & INSTALLATION
OF EIGHT GROUP CONTROLLERS

APPROVED

DATE

ENTERED

Less allowance of 5.00%

Total of above
TOTAL AMOUNT DUE including GST >

Goods remain the property of Verosol (Australia) Pty Ltd until full invoice payment is made. Verosol (Australia) Pty Ltd reserves the right to recover possession of the goods if not paid in full.

Please return with your payment

From: *Schiavello Project Int P/L*
Private Bag 2
Tullamarine VIC 3043

Trading terms :-C.O.D.

ADELAIDE
Tel: (08) 8224 0122
Fax: (08) 8224 0411

BRISBANE
Tel: (07) 3274 4911
Fax: (07) 3274 4899

MELBOURNE
Tel: (03) 9328 2322
Fax: (03) 9328 2383

SYDNEY
Tel: (02) 9784 4141
Fax: (02) 9750 3111

PERTH
Tel: (08) 9228 2622
Fax: (08) 9228 2627